Application for the Vacation of Public Right of Way or Easement City of Lawrence, Kansas

Date Application Submitted: March 30, 2011 Procedures for Vacation Application:

- 1. Complete Vacation Application Form, including legal description.
- 2. Provide ownership list from Douglas County Clerk's Office for property owners within 200 feet of proposed vacation.
- 3. For vacation requests that are not initiated by City staff or the City Commission, please provide a check made payable to "City of Lawrence, Kansas" in the amount of \$200.00. This check should accompany the completed application, and is non-refundable. The application fee covers staff work and publication costs for the notices.

Section 1. Property Owner Information. Provide information on property owner(s) adjoining proposed vacation requesting the vacation:

Name of Property Owner(s): Tenants to Homeowners Inc. Address of Property Owner: 2518 Ridge Ct., Suite 209

Lawrence, Kansas 66046

Telephone Number: 785 842-5494

If the owner is represented by a third party (engineer, architect, attorney) who will serve as the applicant's representative, provide contact information:

J. Dean Grob Grob Engineering Services, LLC 3210 Mesa Way, Suite A Lawrence, Kansas 66049 785 856-1900

Section 2. Background Information.

A) Describe the proposed vacation. What is proposed to be vacated? (e.g. Right-of-way, utility easement, drainage easement).

The proposed vacation is a 10-foot wide utility easement in the western portion of Lot 1.

B) Describe the purpose or reason for seeking the proposed vacation:

The 10' U/E was originally included on the plat to provide Westar a means of servicing a street light. Westar no longer wants to service the street light by this easement and will be serviced by other easement. The revised development plan proposes to have a building where the existing U/E resides so it must be vacated.

- **C)** Attach a copy of the plat of record of the property, indicating the location of the proposed vacation.
- **D)** Attach a copy of the legal description for the portion of the easement or right-of-way which is to be vacated.

Section 3. City Staff Review. The following items will be reviewed by City staff in the Public Works, Utilities and Planning Departments, as applicable.

A)	Will the proposed vacation impair access to a public street by any adjoining property owners?
	No, explain: It is only an unoccupied utility easement.
B)	Are utilities currently located in the easement or right-of-way?
	Water No Sanitary Sewer No Stormsewer No Gas No Electric No Telephone No Cable No
C)	Will the proposed vacation impair the ability of utilities to deliver services to the adjoining property and surrounding area?
	No; there are existing U/E along the perimeter and within the platted lot.
D)	Should the vacation reserve any City rights?
	No
E)	City staff recommendation for the proposed vacation:
	Public Works Planning Utilities

Section 4. After City staff approval, the property owner must execute a Petition for Vacation which will be prepared by City staff. Once a petition has been received, notice of the hearing on vacation will be published. The City Commission will consider the proposed vacation at the hearing, and if appropriate, authorize the Mayor to execute the Order of Vacation which vacates the easement or right-of-way.


Legal Description of Property


LOT 1, PRAIRIE WIND ADDITION, A SUBDIVISION IN THE CITY OF LAWRENCE, DOUGLAS COUNTY, KANSAS, CONTAINING 3.04 ACRES MORE OR LESS.

Legal Description of Easement to be Vacated

THAT PART OF LOT 1, PRAIRIE WIND ADDITION, A SUBDIVISION IN THE CITY OF LAWRENCE, DOUGLAS COUNTY, KANSAS, DESCRIBED AS FOLLOWS;

COMMENCING AT THE SOUTHWEST CORNER OF SAID LOT 1; THENCE NORTH 89°16'52" EAST ALONG THE SOUTH LINE OF SAID LOT 1, 15.00 FEET; THENCE NORTH 00°00'00" WEST PARALLEL TO THE WEST LINE OF SAID LOT 1, 131.95 FEET TO THE POINT OF BEGINNING; THENCE NORTH 89°16'52" EAST, 82.01 FEET; THENCE NORTH 00°00'00" WEST, 10.00 FEET; THENCE SOUTH 89°16'52" WEST, 82.01 FEET; THENCE SOUTH 00°00'00" EAST, 10.00 FEET TO THE POINT OF BEGINNING. THE EASEMENT CONTAINS 0.019 ACRES MORE OR LESS.

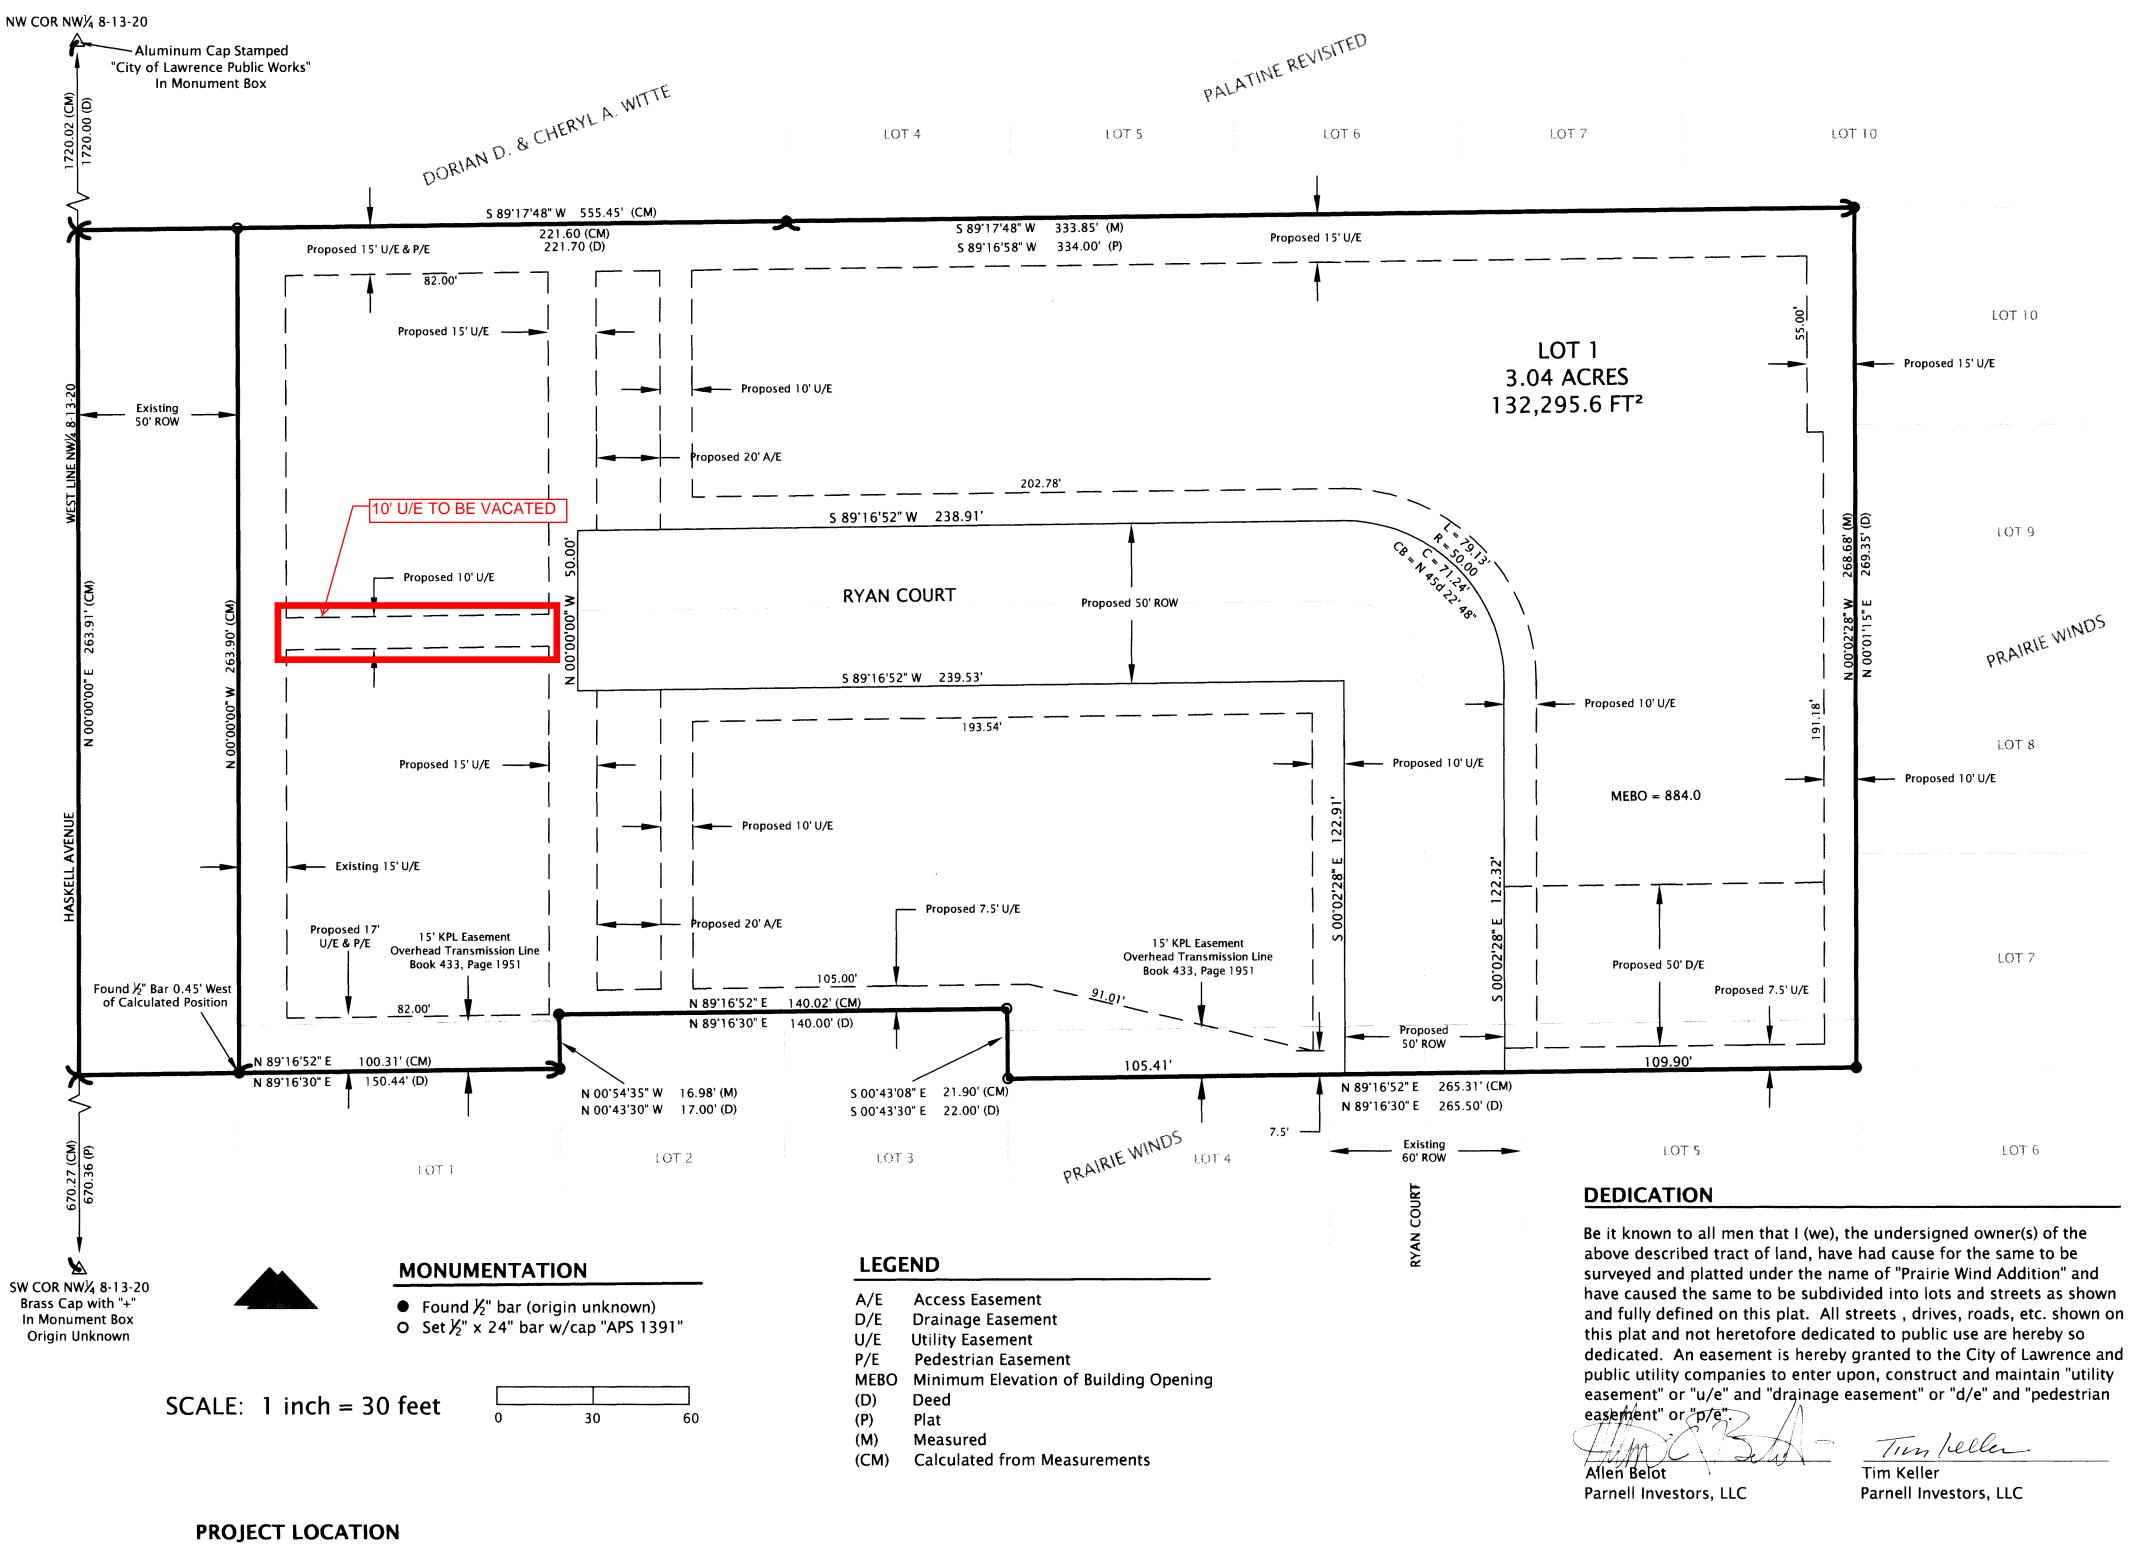

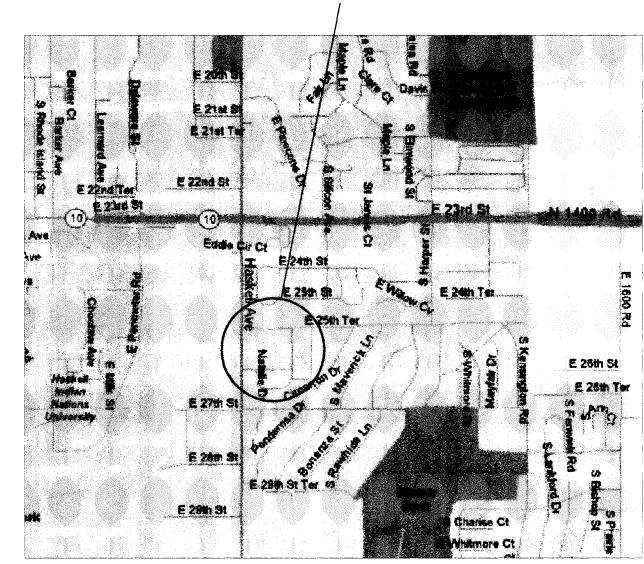

LEGAL DESCRIPTION

A TRACT OF LAND IN THE NORTHWEST QUARTER OF SECTION 8, TOWNSHIP 13 SOUTH, RANGE 20 EAST OF THE SIXTH PRINCIPAL MERIDIAN, IN THE CITY OF LAWRENCE, DOUGLAS COUNTY, KANSAS, NOW DESCRIBED AS FOLLOWS: COMMENCING AT A POINT ON THE WEST LINE OF SAID QUARTER SECTION, SAID POINT BEING 1983.93 FEET SOUTH OF THE NORTHWEST CORNER OF SAID QUARTER SECTION; THENCE NORTH 89 DEGREES, 16 MINUTES, 52 SECONDS EAST, 50.00 FEET TO THE POINT OF BEGINNING, SAID POINT BEING ON THE EAST ROAD RIGHT-OF-WAY OF HASKELL AVENUE; THENCE NORTH 89 DEGREES, 16 MINUTES, 52 SECONDS EAST, 100.31 FEET TO A 1/2" BAR FOUND AT THE NORTHEAST CORNER OF LOT 1, BLOCK 4, PRAIRIE WINDS, AN ADDITION TO SAID CITY OF LAWRENCE; THENCE NORTH 00 DEGREES, 54 MINUTES, 35 SECONDS WEST, 16.98 FEET TO A 1/2" BAR FOUND AT THE NORTHWEST CORNER OF LOT 2, BLOCK 4 IN SAID PRAIRIE WINDS; THENCE NORTH 89 DEGREES, 16 MINUTES, 52 SECONDS EAST, 140.02 FEET TO THE NORTHEAST CORNER OF LOT 3, BLOCK 4 IN SAID PRAIRIE WINDS; THENCE SOUTH 00 DEGREES, 43 MINUTES, 08 SECONDS EAST, 21.90 FEET TO THE NORTHWEST CORNER OF LOT 4, BLOCK 4 IN SAID PRAIRIE WINDS; THENCE NORTH 89 DEGREES, 16 MINUTES, 52 SECONDS EAST, 265.31 FEET TO A 1/2" BAR FOUND AT THE NORTHWEST CORNER OF LOT 6, BLOCK 4 IN SAID PRAIRIE WINDS; THENCE NORTH 00 DEGREES, 02 MINUTES, 28 SECONDS WEST, 268.68 FEET TO A 1/2" BAR FOUND AT THE NORTHWEST CORNER OF LOT 10, BLOCK 4 IN SAID PRAIRIE WINDS; THENCE SOUTH 89 DEGREES, 17 MINUTES, 48 SECONDS WEST, 505.45 FEET TO A POINT ON SAID EAST ROAD RIGHT-OF-WAY OF HASKELL AVENUE; THENCE SOUTH 00 DEGREES, 00 MINUTES, 00 SECONDS WEST ALONG SAID ROAD RIGHT-OF WAY, 263.90 FEET TO THE POINT OF BEGINNING.

- 1. Basis for bearings for this plat is the West line of the Northwest Quarter of Section 8, Township 13 South, Range 20 East (N 00° 00' 00" - Assumed).
- 2. Plat is a closed traverse. Error of closure: 0.0011 Course: N 32-43-24 E Error North: 0.00090 East: 0.00058
- 3. Street trees shall be provided in accordance with the master street Page _ 2624

Precision 1: 1,438,681.82

- 4. The City is hereby granted a temporary right of entry to plant the required street trees pursuant to Chapter 21, Article 7, Section 21-708a of the City Subdivision Regulations.
- 5. Adjacent property owners are required to maintain all drainage easements not owned by the City. Structures, fences, and cut/fill operations are prohibited within drainage easements.
- 6. The lot will be pinned prior to recordation of the final plat at the Register of Deeds Office (per Section 21-302.2).
- 7. An SWP3 plan will be provided and approved prior to construction activity, including earthwork, removal of existing vegetation and issuance of building permits.
- 8. The detention area will be privately-owned and maintained. The developer is responsible for establishing ownership and maintenance of same via individual owner maintenance.
- 9. Referenced Deeds:

NOTES

Deed to Thervald Holmes Jr. and Elaine M. Holmes Book 425, Page 2016. Deed to Dorian D. and Cheryl A. Witte Book 553, Page 1896

ENDORSEMENTS

Approved by City of Lawrence Planning Commission Douglas County, Kansas

Rights-of-Way and Easements Accepted by City Commission Lawrence, Kansas

Chairperson Grant Eichhorn Sue Hack

City Clerk Date Frank S. Reeb

Michael D. Kellv. P.L.S. #869 Douglas County Surveyor Reviewed in accordance with


K.S.A. 58-2005.

ACKNOWLEDGEMENT

State of Kansas County of Douglas

Be it remembered that on this _d_ 2008, before me, the undersigned, a notary public, in and for said county and state, came The last who is (are) personally known to me to be the same person(s) who executed the foregoing instrument of writing and duly acknowledge the execution of the same.

In witness whereof, I have hereunto set my hand and affixed my seal on the day and year last written above.

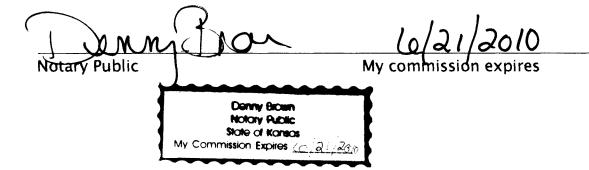

FILING RECORD

State of Kansas County of Douglas


This is to certify that this instrument was filed for record in the office June, 2008, and is duly recorded at 4:36 AM PM in plat book 18 page 231



SURVEYOR'S CERTIFICATION

I hereby certify that the platted area shown hereon is the true and accurate result of a field survey performed under my direct supervision in July 2006, and that the plat is a closed traverse.

Steven D. Williams, P.L.S. #1391 P.O. Box 4444 Lawrence, KS 66046 (785)832-2121

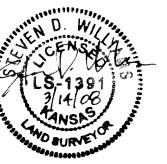

ENGINEER'S CERTIFICATION

I hereby certify that the information and area map shown hereon are true and accurate to the best of my knowledge. Plat prepared March,

John Dean Grob Professional Engineer #12769 P.O. Box 502 Lawrence, KS 66044 (785)856-1900



a final plat of PRAIRIE WIND ADDITION

A Subdivision in the City of Lawrence, Douglas County, Kansas NW¼ Section 8, Township 13 South, Range 20 East