



2011 Comprehensive Street Maintenance Program (As-Built)

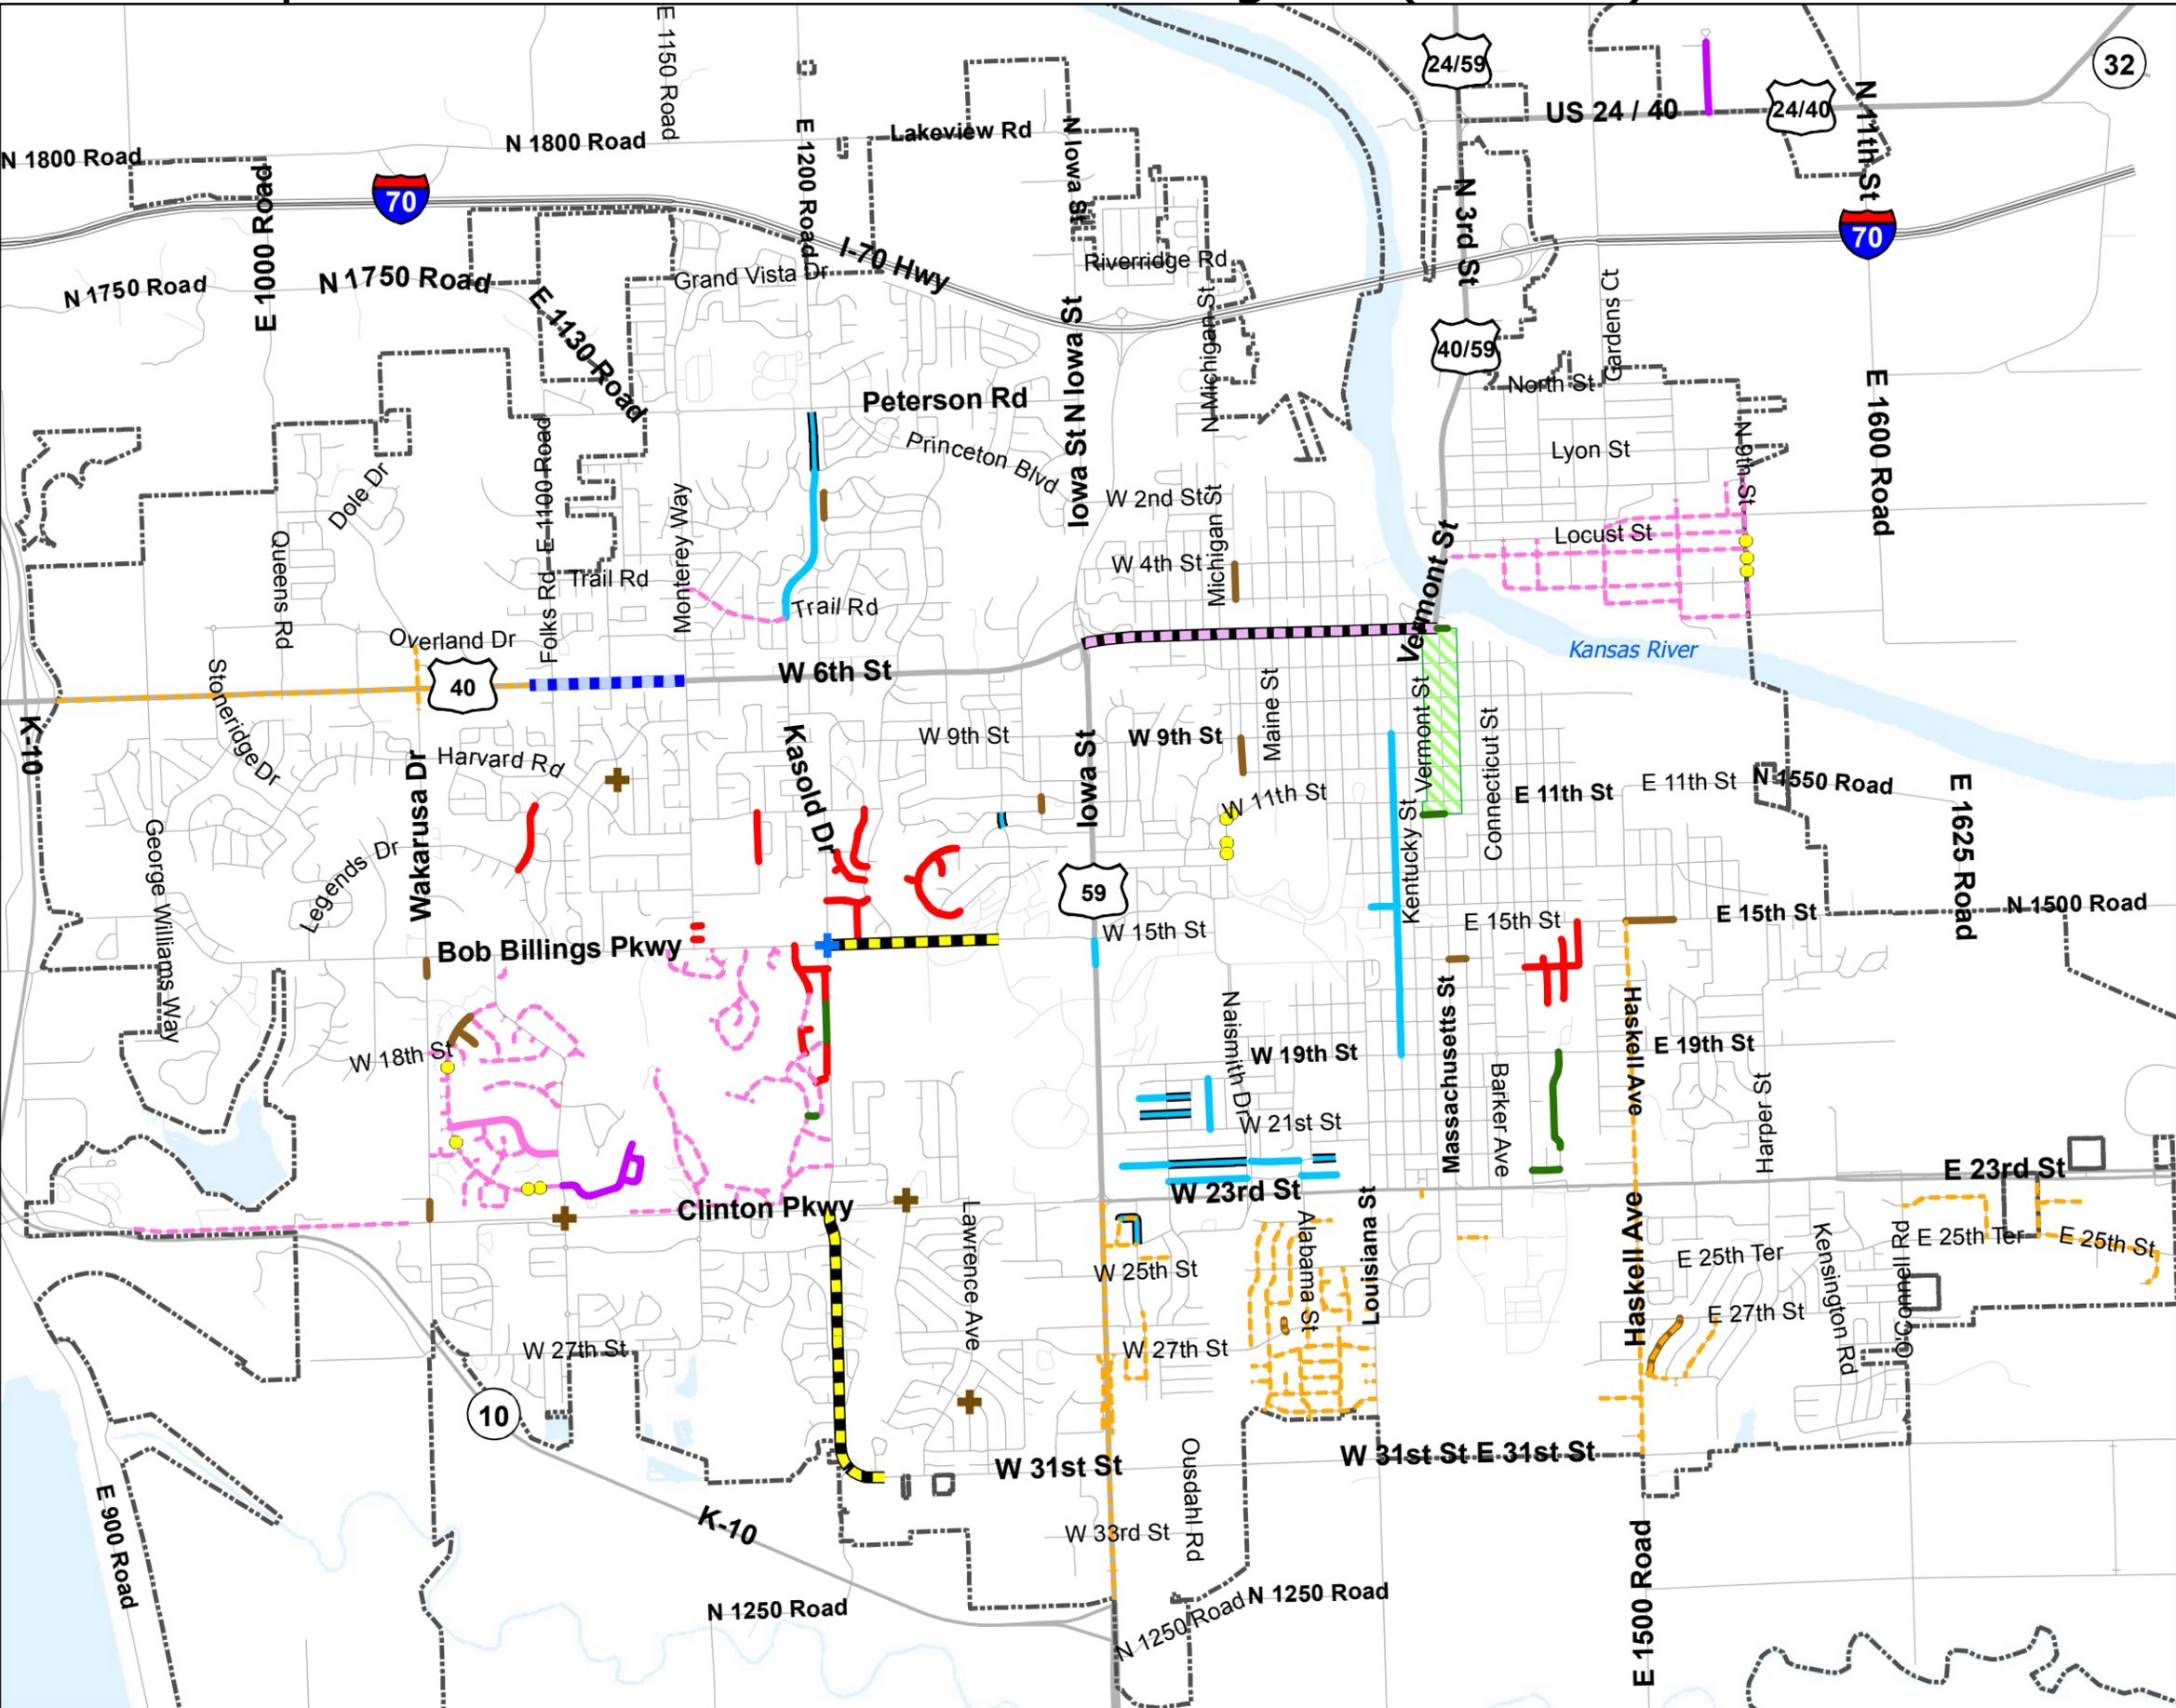

- Speed Cushions/Humps
- + Intersection (Phase 2 Mill and Overlay)
- + Internal Intersection
- Asphalt Area Patching
- Internal Street Maintenance
- - - Crack Sealing Program
- - - Microsurface Program
- Mill & Overlay (part of MS Program)
- ▬▬▬ CIP 2011
- ▬▬▬ KLINK 2011
- ▬▬▬ Street Widening & Geometric Improvement
- Phase 1, Mill and Overlay
- Phase 2, Mill and Overlay
- ▬▬▬ Phase 2, Mill, Overlay, Curb & Gutter
- Concrete Rehab (contracted)
- ▨▨▨ Miscellaneous Concrete Repairs

Updated: 1/23/2012

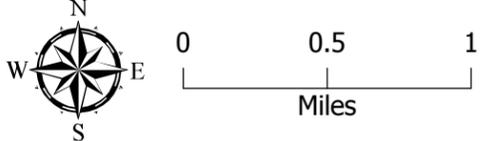

DISCLAIMER NOTICE The map is provided "as is" without warranty or any representation of accuracy, timeliness or completeness. The burden for determining accuracy, completeness, timeliness, merchantability and fitness for or the appropriateness for use rests solely on the requester. The City of Lawrence makes no warranties, express or implied, as to the use of the map. There are no implied warranties of merchantability or fitness for a particular purpose. The requester acknowledges and accepts the limitations of the map, including the fact that the map is dynamic and is in a constant state of maintenance, correction and update.