


# 2015 Comprehensive Street Maintenance Program - As Built

Date: 12/30/2015

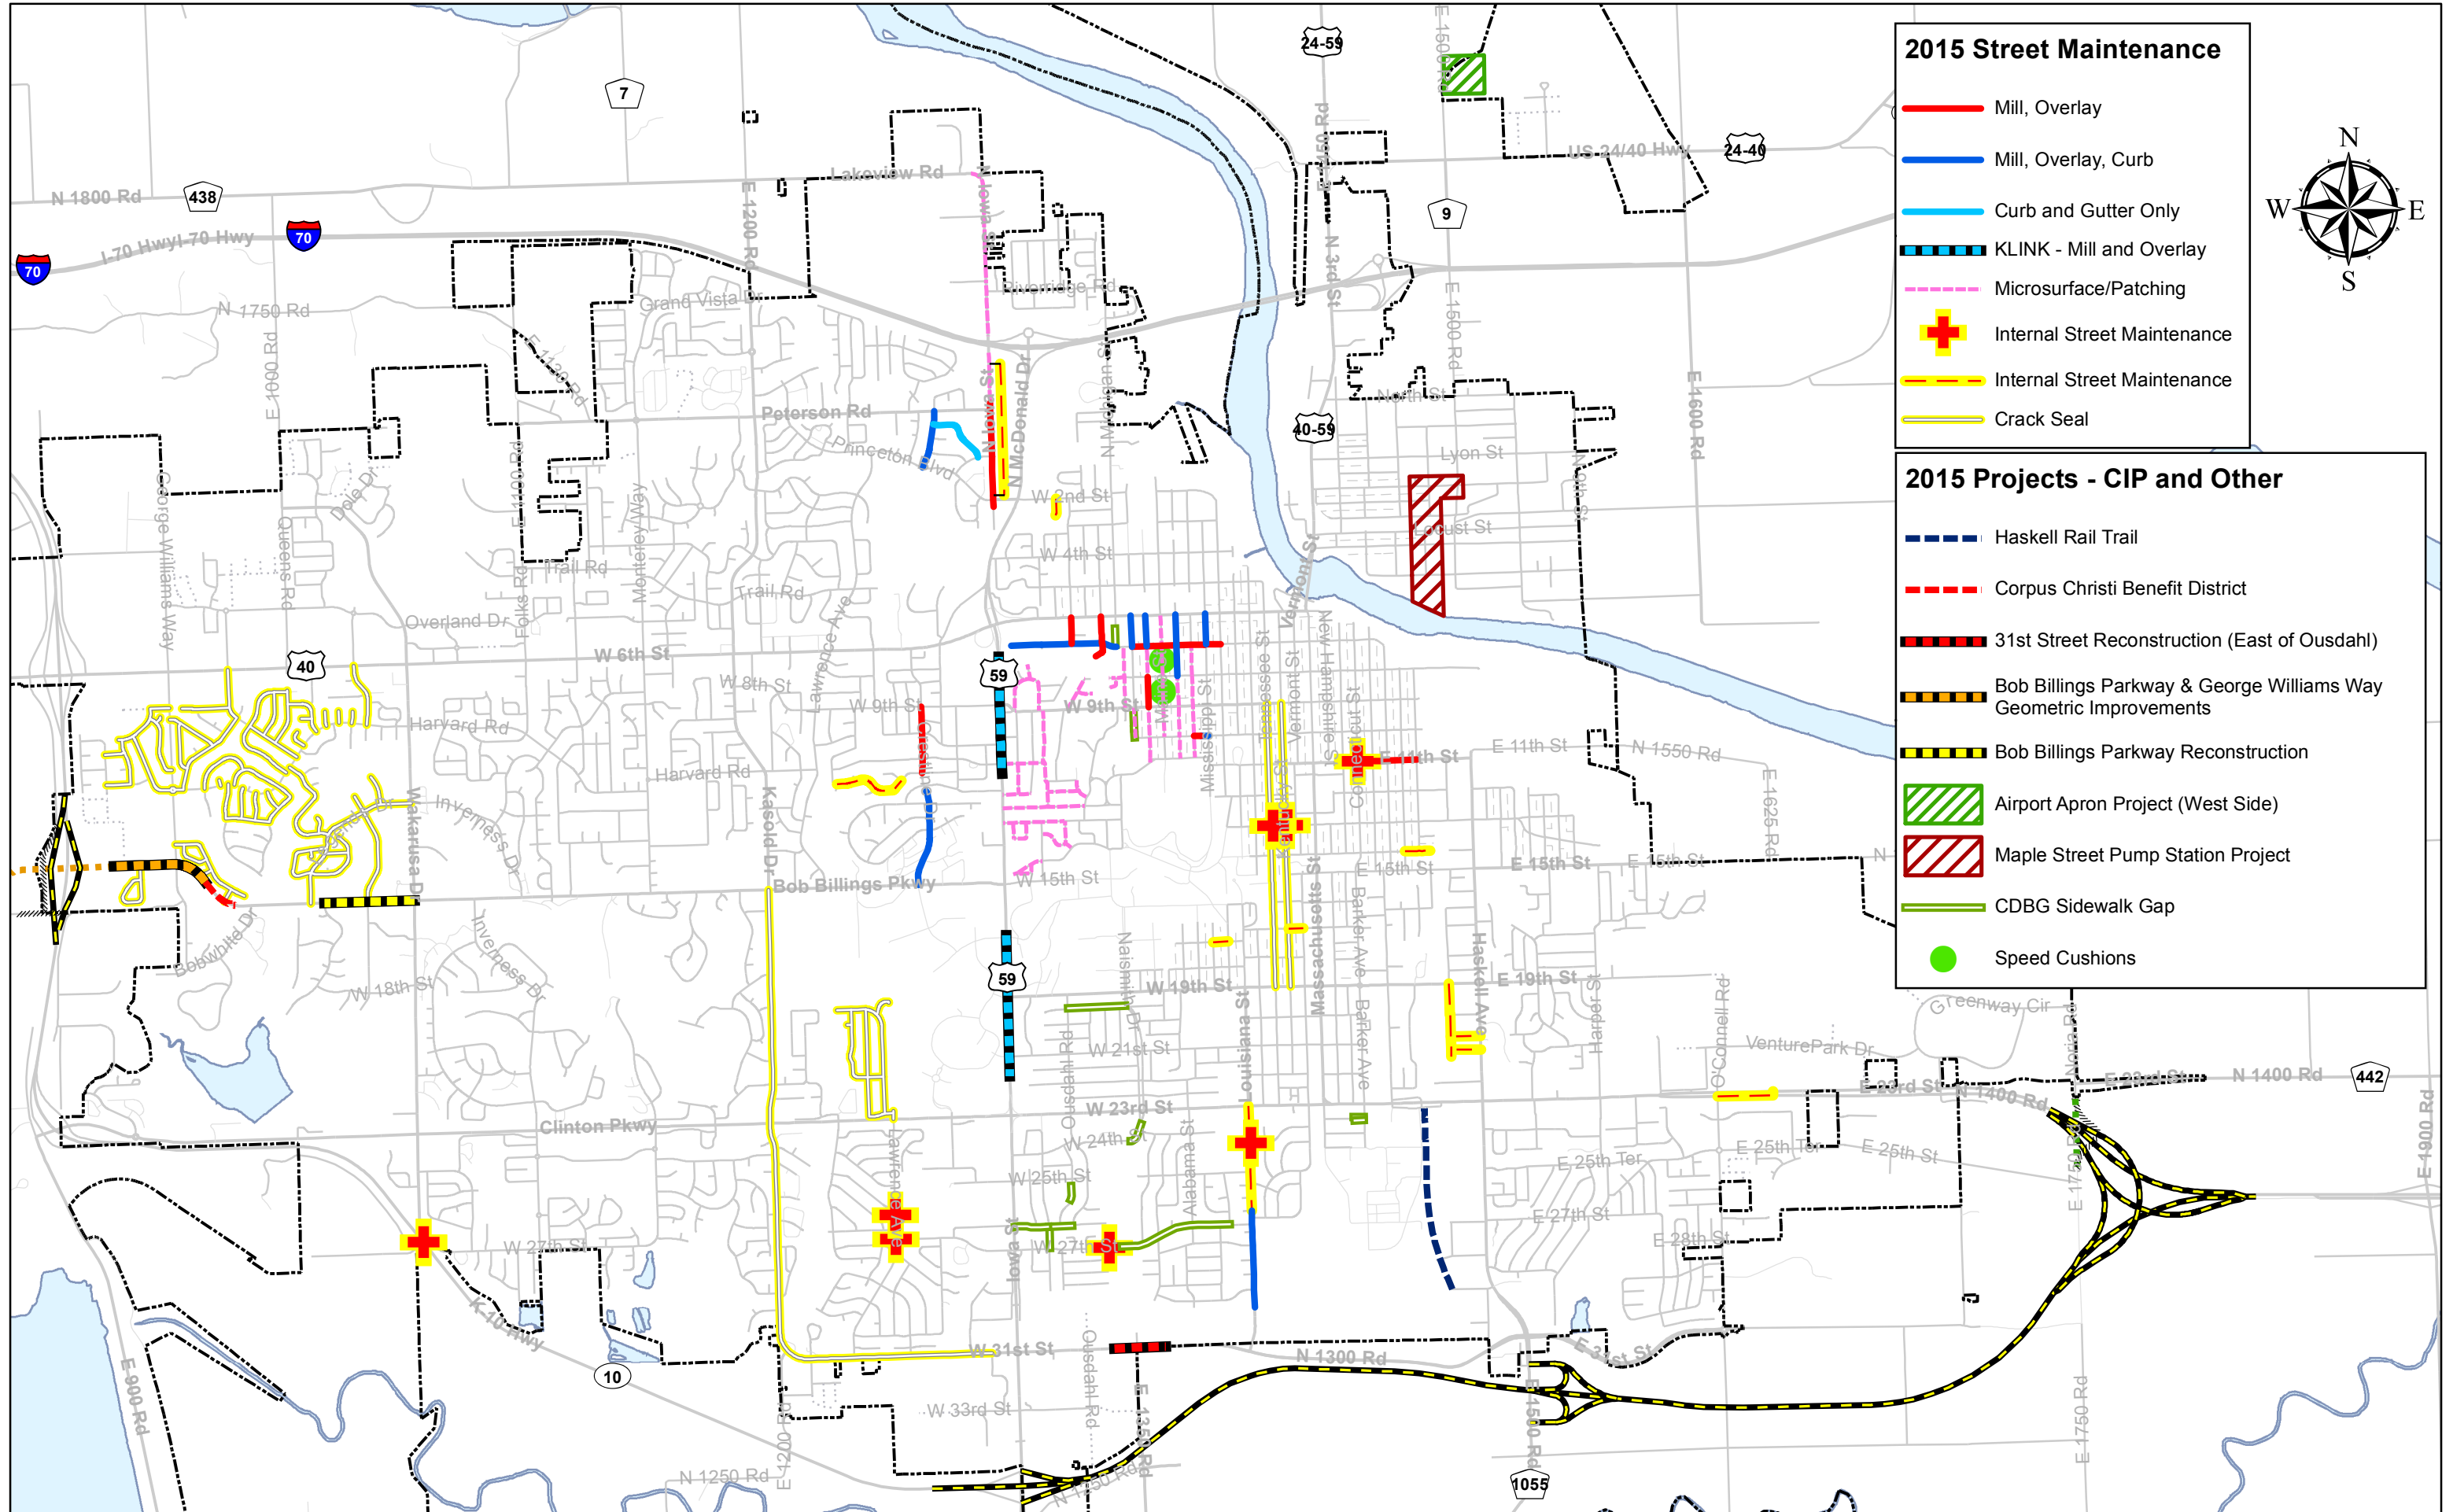

- ### 2015 Street Maintenance
- Mill, Overlay
  - Mill, Overlay, Curb
  - Curb and Gutter Only
  - KLINK - Mill and Overlay
  - Microsurface/Patching
  - + Internal Street Maintenance
  - Internal Street Maintenance
  - Crack Seal

- ### 2015 Projects - CIP and Other
- Haskell Rail Trail
  - Corpus Christi Benefit District
  - 31st Street Reconstruction (East of Ousdahl)
  - Bob Billings Parkway & George Williams Way Geometric Improvements
  - Bob Billings Parkway Reconstruction
  - Airport Apron Project (West Side)
  - Maple Street Pump Station Project
  - CDBG Sidewalk Gap
  - Speed Cushions

