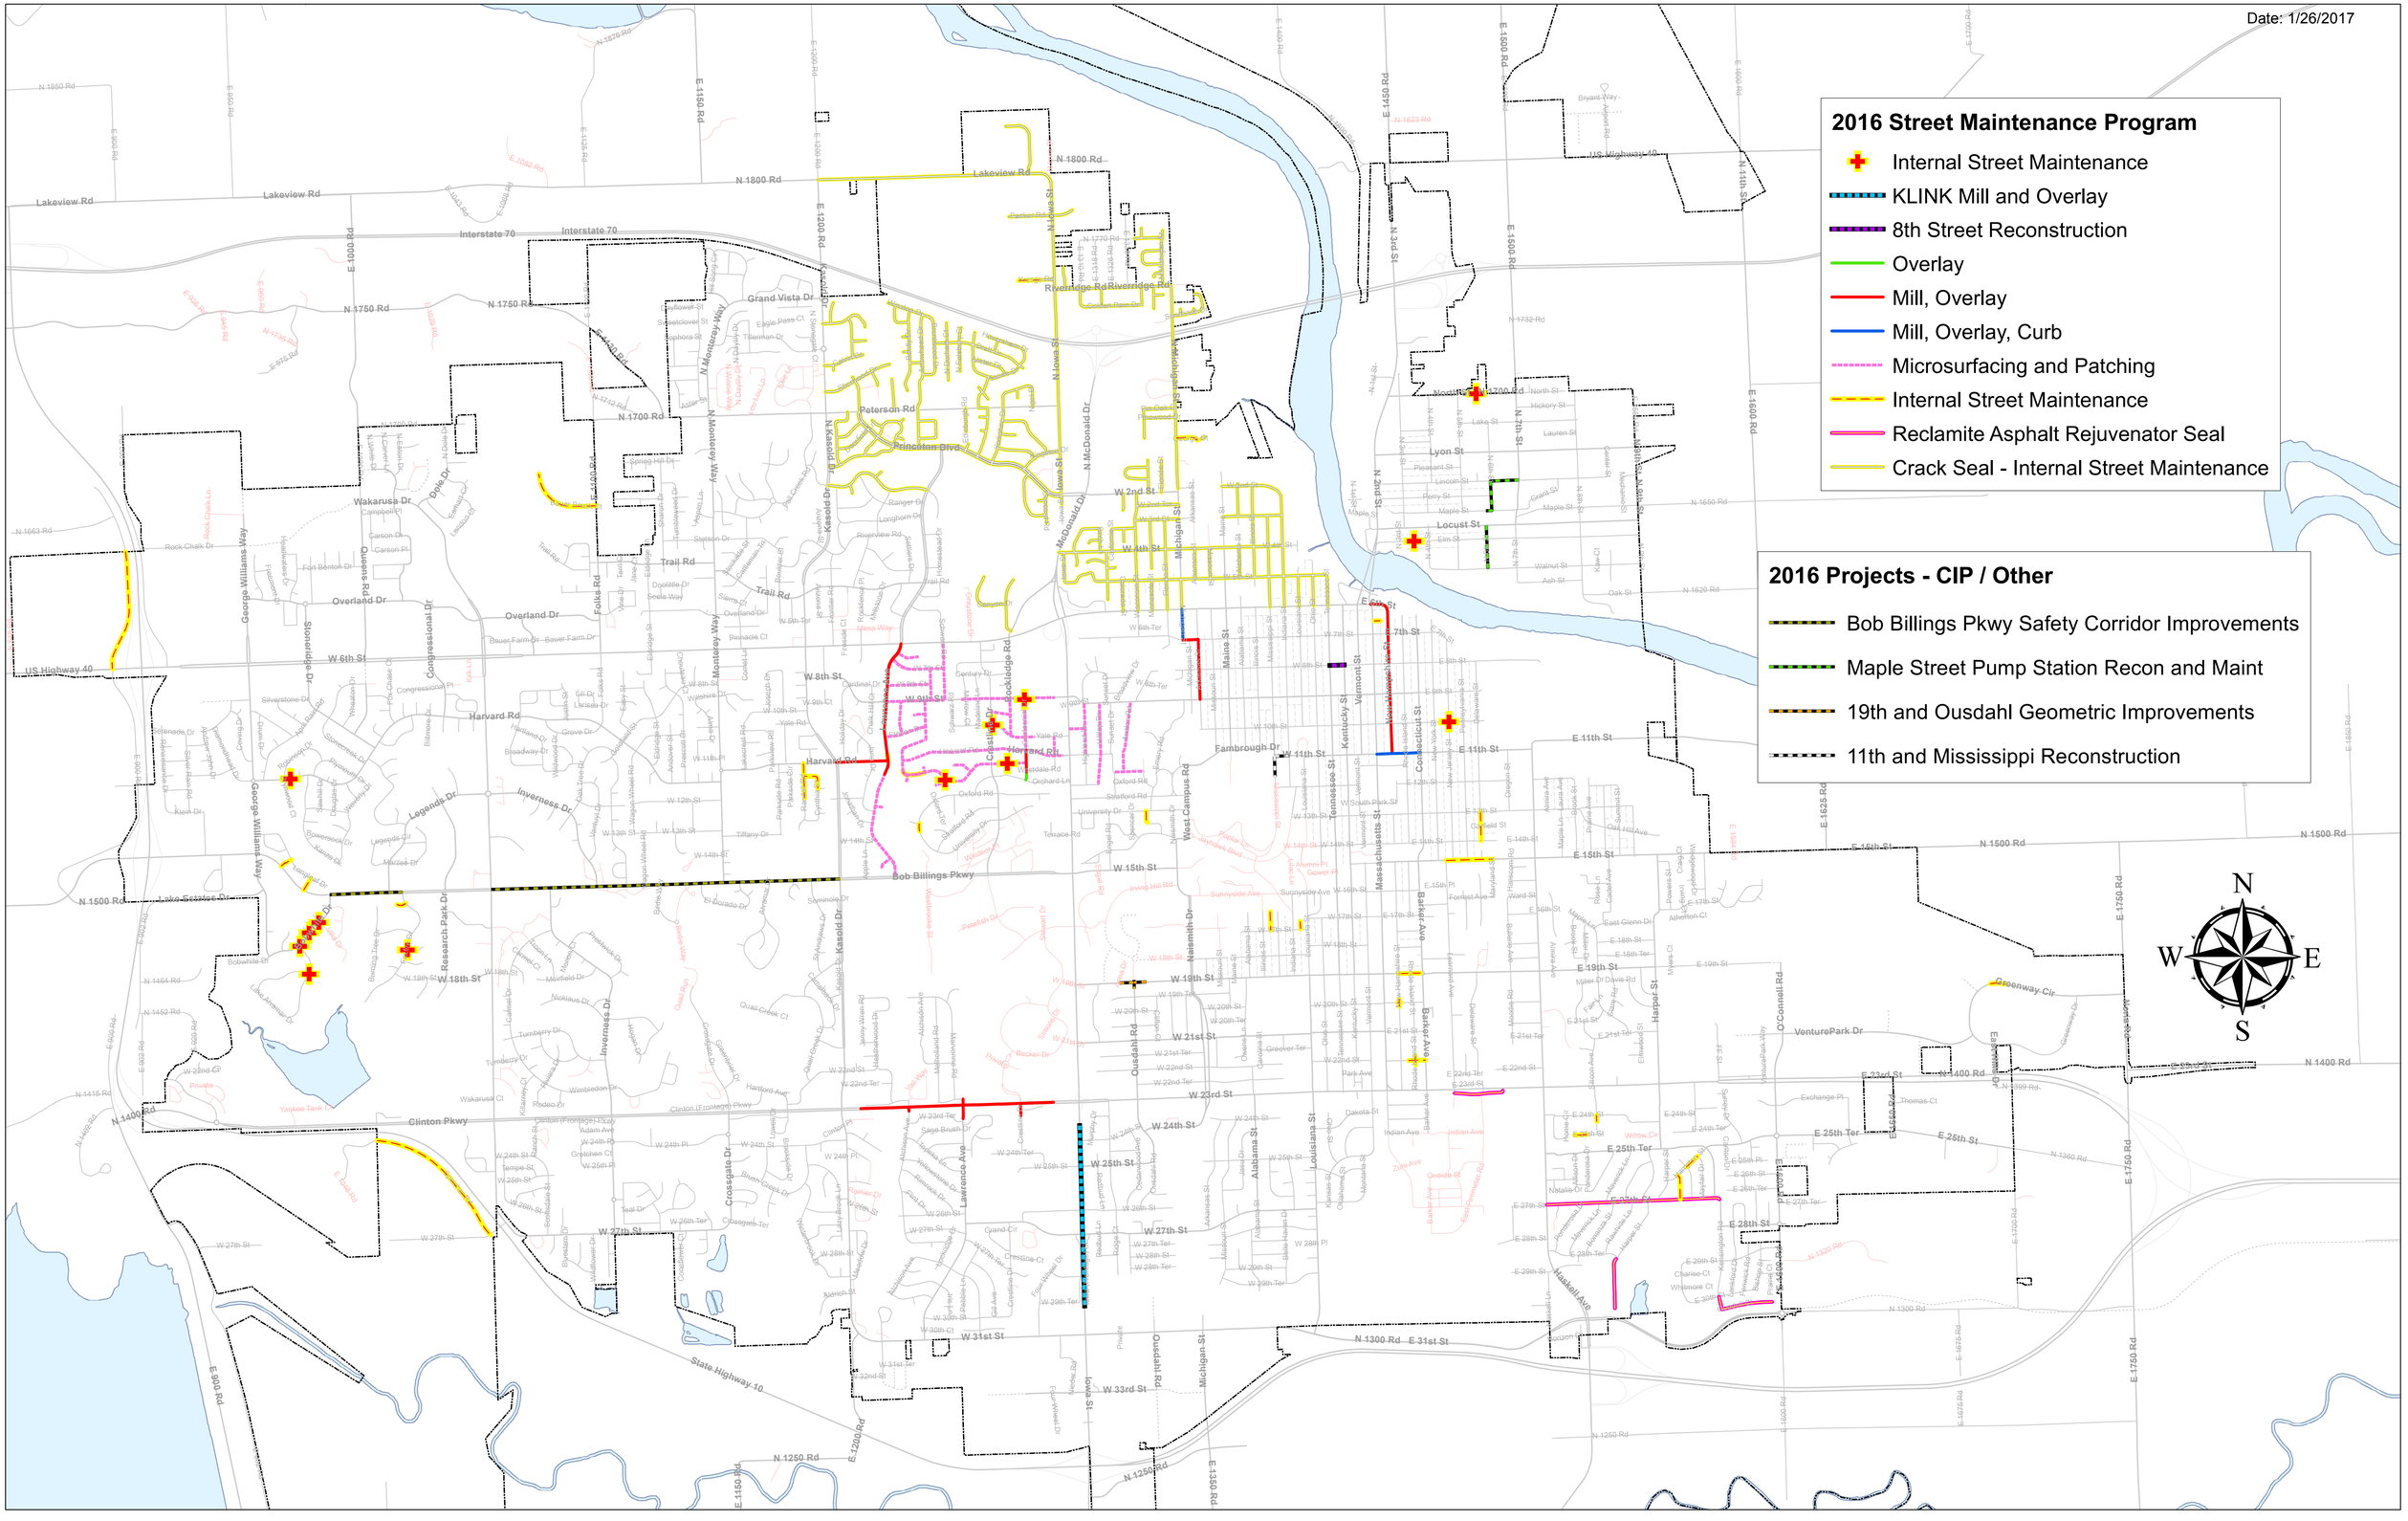2016 Comprehensive Street Maintenance Program - As Built